


PLAN
45th STREET

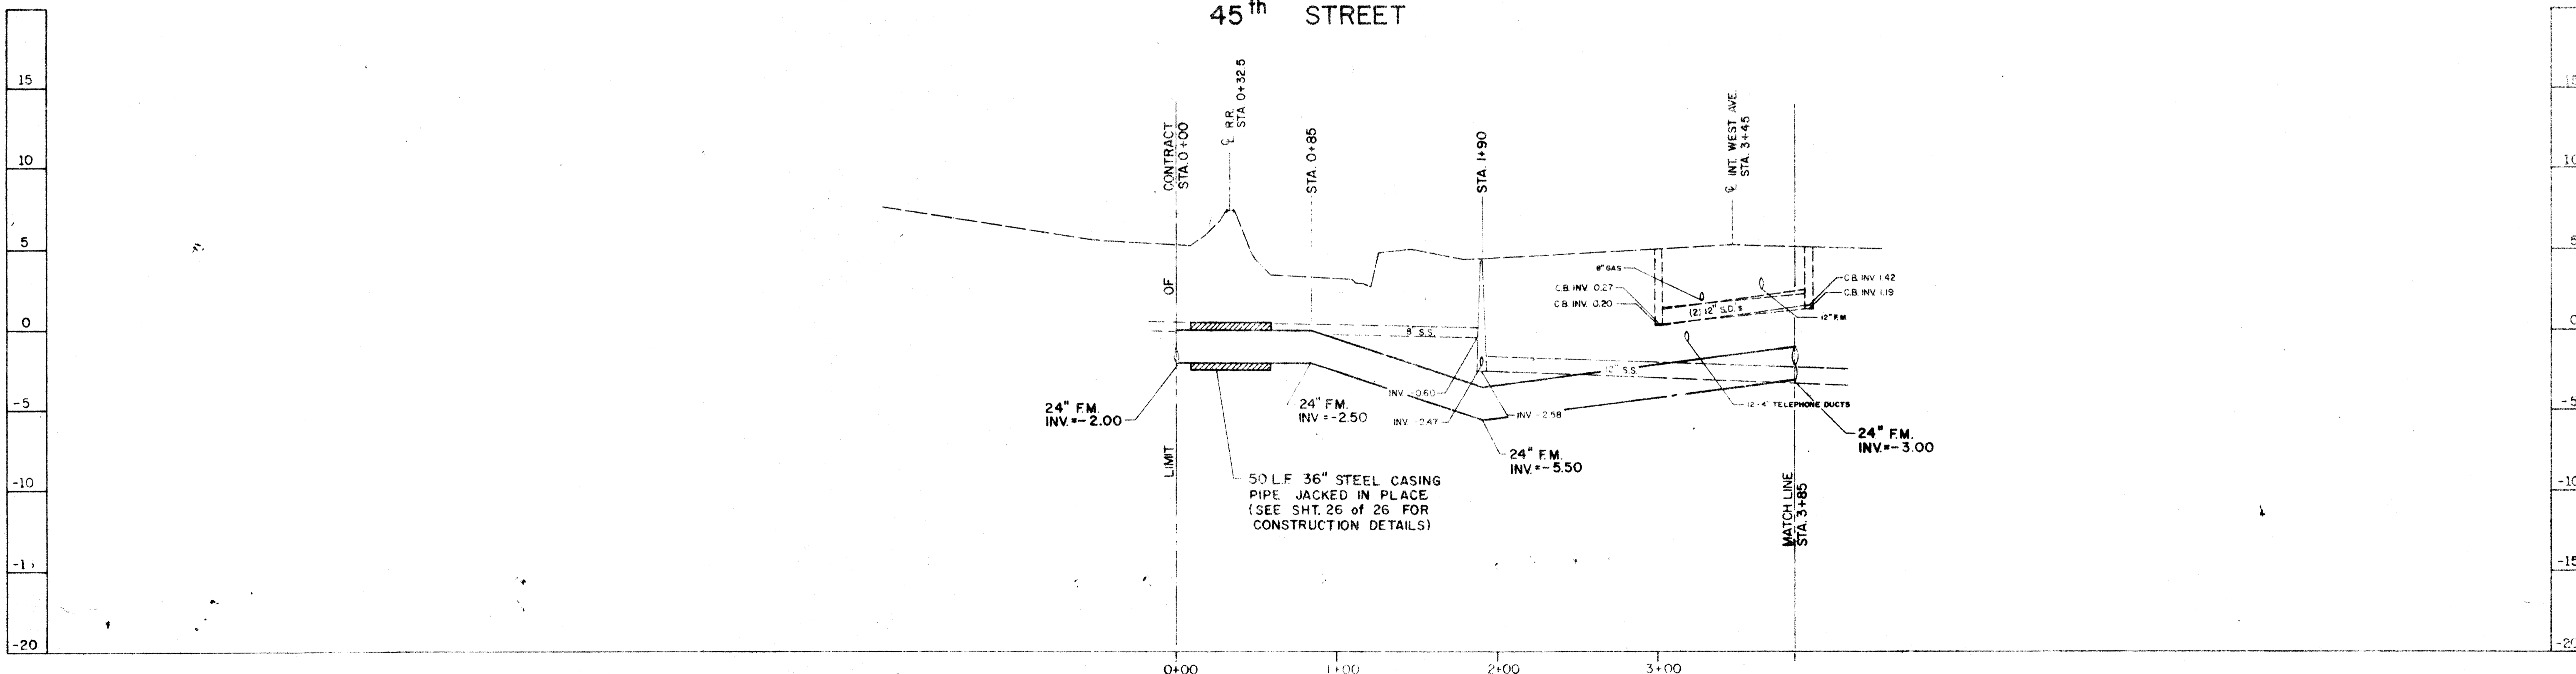

RECORD DRAWING

PANDULLO QUIRK ASSOCIATES
 CONSULTING CIVIL ENGINEERS
 PASSAIC, CAPE MAY AND ATLANTIC COUNTIES NEW JERSEY

DATE: W/1
 DRAWN: W/1
 CHECKED: W/1
 PROJECT NO. 1033

APPROVAL
 PROJ. MGR. _____

FRANCIS PANDULLO
 PROFESSIONAL ENGINEER
 N.J. LIC. NO. 11626 DATE _____

CAPE MAY COUNTY MUNICIPAL UTILITIES AUTHORITY
 CAPE MAY COUNTY NEW JERSEY
OCEAN CITY REGION
FORCE MAINS - CONTRACT O.C.-F1-G

45th ST.
 PLANS AND PROFILE
 STA. 0+00 TO STA. 3+85

PROJECT NO. 61413
 DWG. 2 OF 26