


DESIGNED BY
DRAWN BY
CHECKED BY


COMPOSITE
OVERLAY
SCREEN
OVERLAY IDENTIFICATION
PROJID
FILE

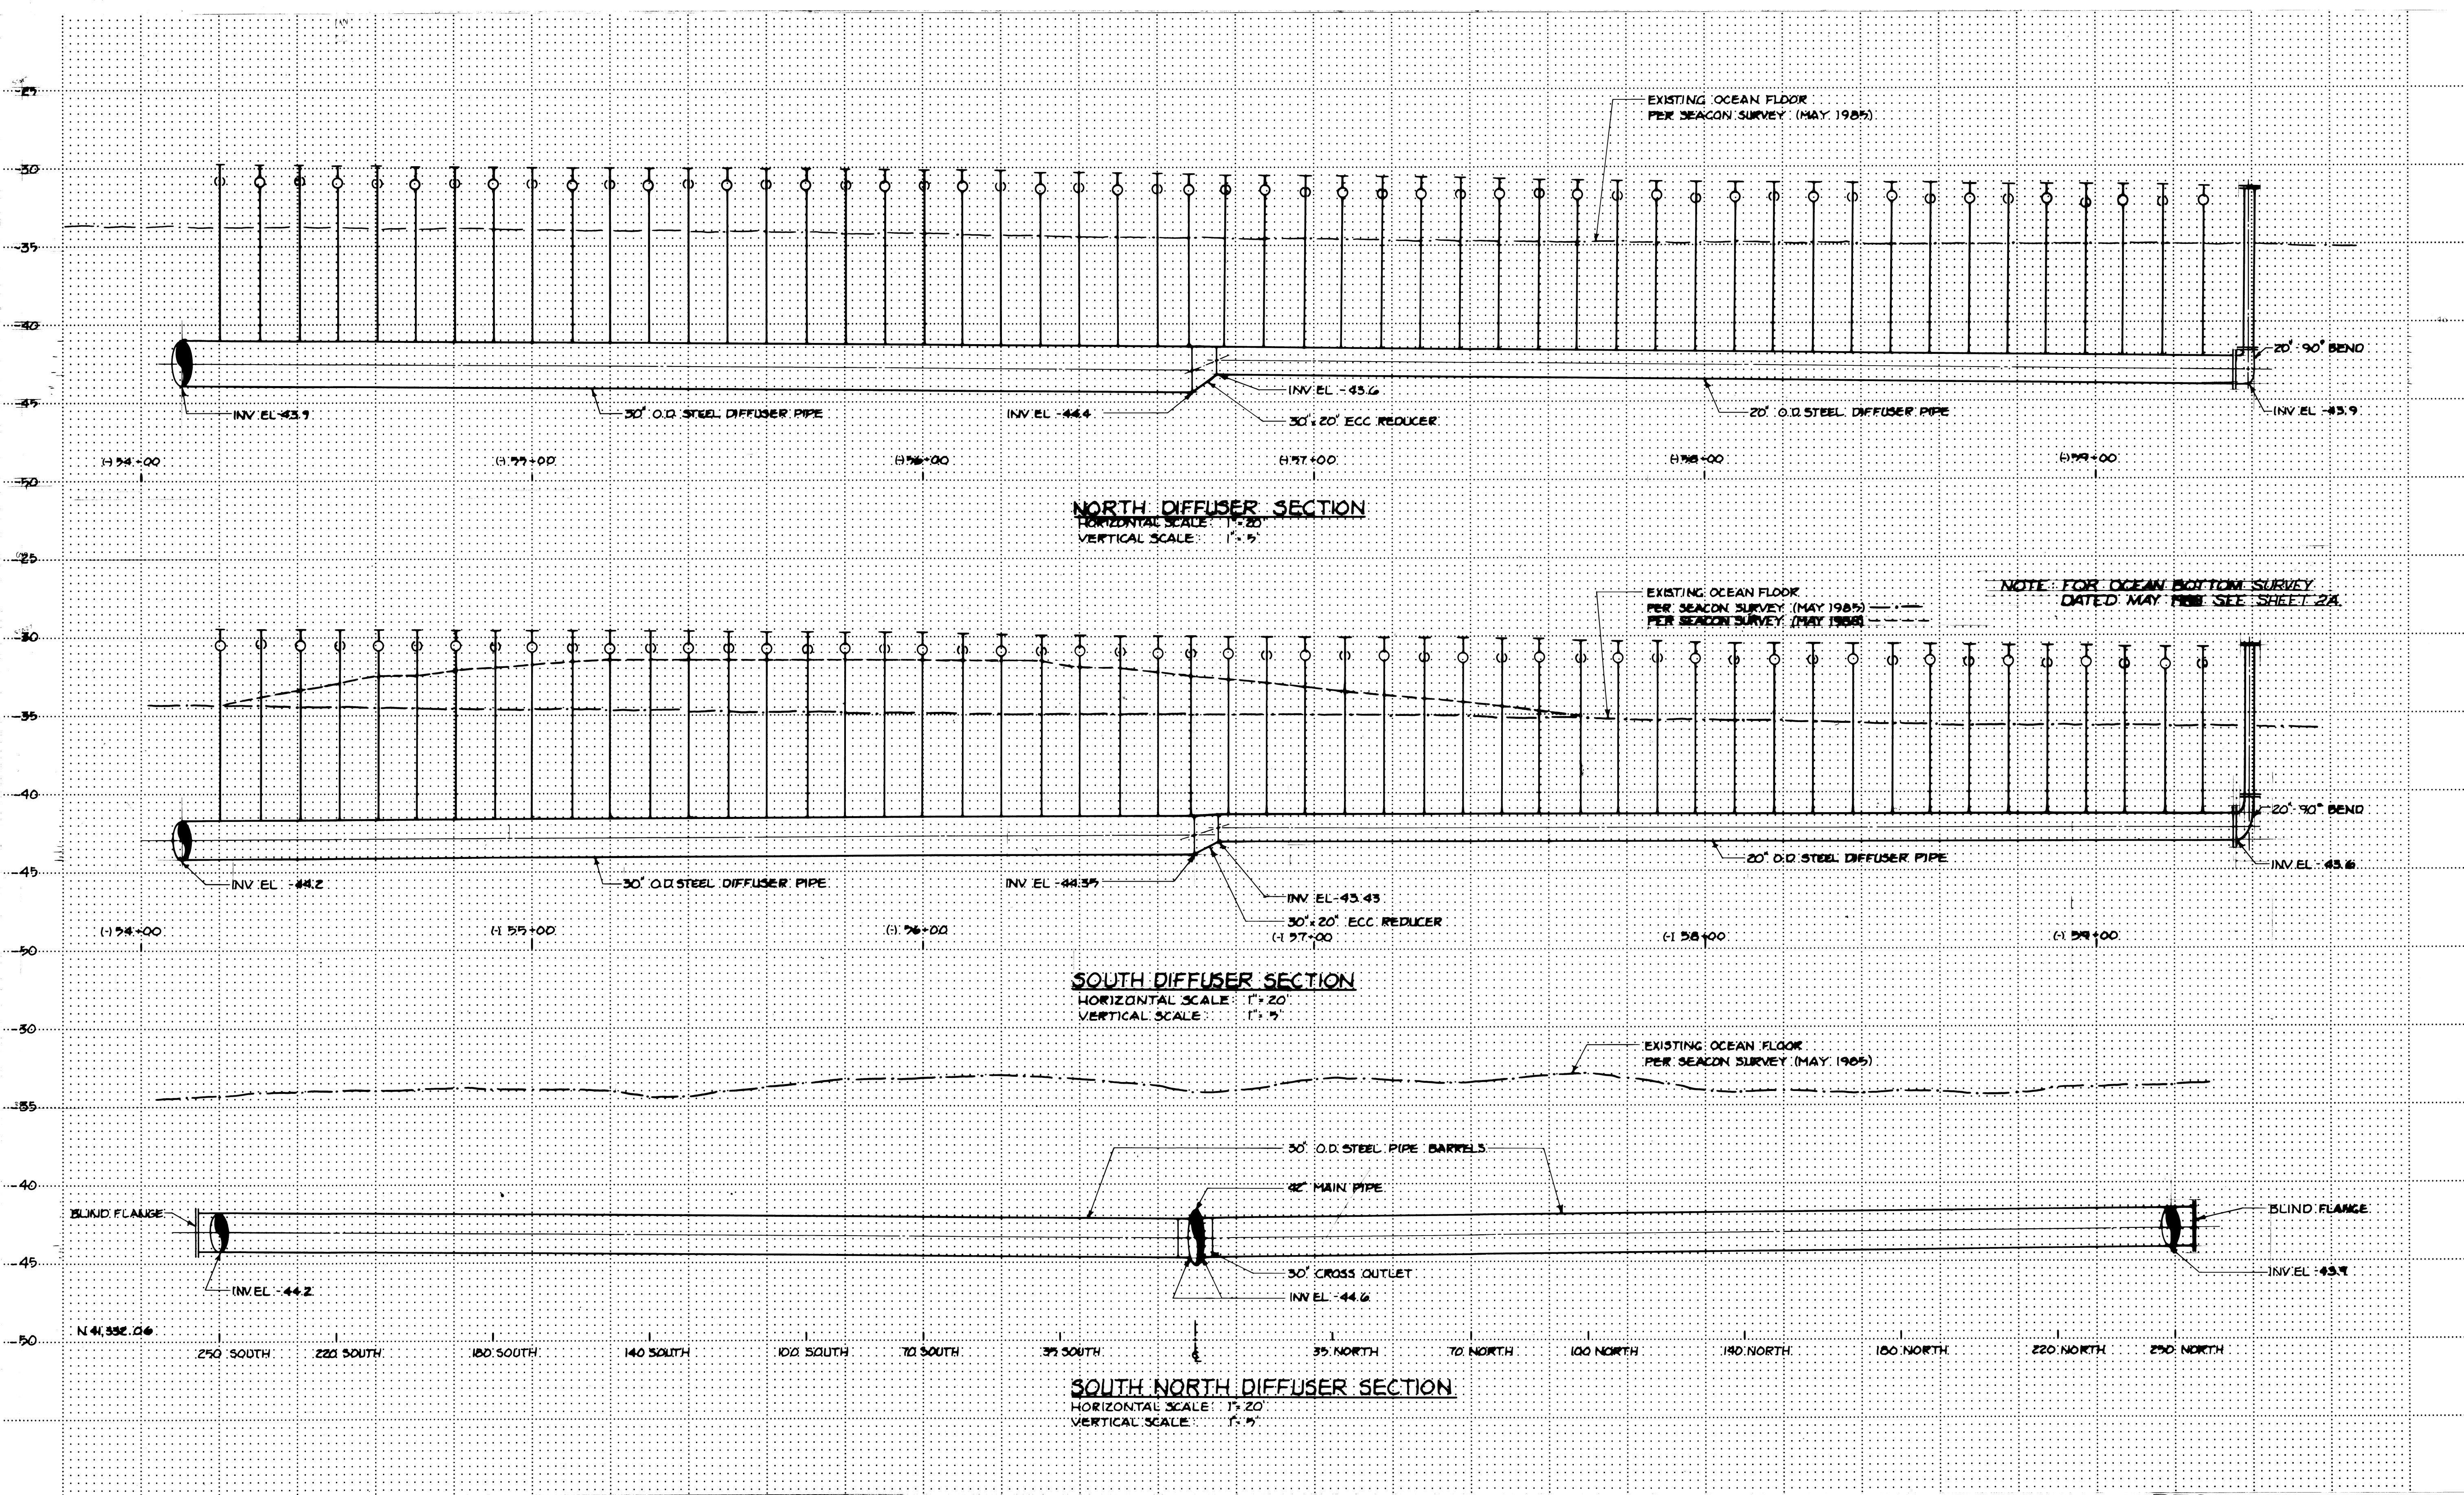

RECORD DRAWINGS

Revisions Drawn by *D. Barrick* Date *Feb 12, 1988*

THESE RECORD DRAWINGS HAVE BEEN PREPARED, IN PART, ON THE BASIS OF INFORMATION COMPILED BY OTHERS. THEY ARE NOT INTENDED TO REPRESENT IN DETAIL THE EXACT LOCATION, TYPE OF COMPONENT NOR MANNER OF CONSTRUCTION. THE ENGINEER WILL NOT BE RESPONSIBLE FOR ANY ERRORS OR OMISSIONS WHICH HAVE BEEN INCORPORATED INTO THE RECORD DRAWINGS.

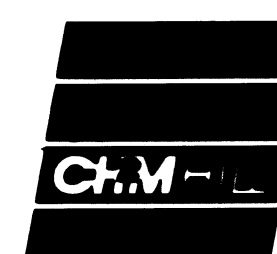

DSGN B. ALTARATZ					
DR A. DURLLEY					
CHK N. ELMER					
APVD V. RYBEL					
NO.	DATE	REVISION	BY	APVD	

REUSE OF DOCUMENTS
THIS DOCUMENT, AND THE IDEAS AND DESIGNS INCORPORATED HEREIN, AS AN INSTRUMENT OF PROFESSIONAL SERVICE, IS THE PROPERTY OF CH2M HILL AND IS NOT TO BE USED, IN WHOLE OR IN PART, FOR ANY OTHER PROJECT WITHOUT THE WRITTEN AUTHORIZATION OF CH2M HILL.
© CH2M HILL, INC.

BAR IS ONE INCH ON ORIGINAL DRAWING.
IF NOT ONE INCH ON THIS SHEET, ADJUST SCALES ACCORDINGLY.

CAPE MAY MUNICIPAL UTILITY AUTHORITY
CAPE MAY COUNTY NEW JERSEY
WILDWOOD/LOWER REGION
OCEAN OUTFALL

DIFFUSER PROFILE	
SHEET	4A
DWG NO.	
DATE	JULY 1986
PROJ NO.	W18167.G3