

CAPE MAY COUNTY MUNICIPAL UTILITIES AUTHORITY  
1523 Route 9 North  
Cape May Court House, NJ 08210  
Phone: (609) 465-9026 Fax: (609) 465-9025

ADDENDUM NO. 1  
to the  
CONTRACT DOCUMENTS

FURNISHING AND DELIVERY OF ROTATING BIOLOGICAL CONTACTORS (RBC'S)  
TO THE CAPE MAY WASTEWATER TREATMENT FACILITY  
CONTRACT CM-EQUIP-29-20

---

To All Document Holders:




The following changes, additions and/or deletions are hereby made a part of the Contract Documents for the above referenced contract as fully and completely as if the same were fully set forth herein:

**SPECIFICATIONS**

1. Record Drawings of the existing Cape May Wastewater Treatment Facility RBC's have been uploaded to the Authority's Bid Portal under Appendix A for download. Record drawings were prepared by Pandullo Quirk Associates and consist of the following items:
  - Sheet 30 - "Cape May Region Wastewater Treatment Facilities: Rotating Biological Contactors Plan"
  - Sheet 31 - "Cape May Region Wastewater Treatment Facilities: Rotating Biological Contactors Plan"

**All bidders shall acknowledge the receipt and acceptance of this Addendum No. 1 by indicating the Addendum Number in the space provided on the Proposal. Bids submitted without this Addendum acknowledgement will be considered non-responsive.**

REVISIONS				
DATE	BY	CHK'D	APP'D	DESCRIPTION
12-30-83	BA	PJB	F5	CHANNEL AIR ADDITION

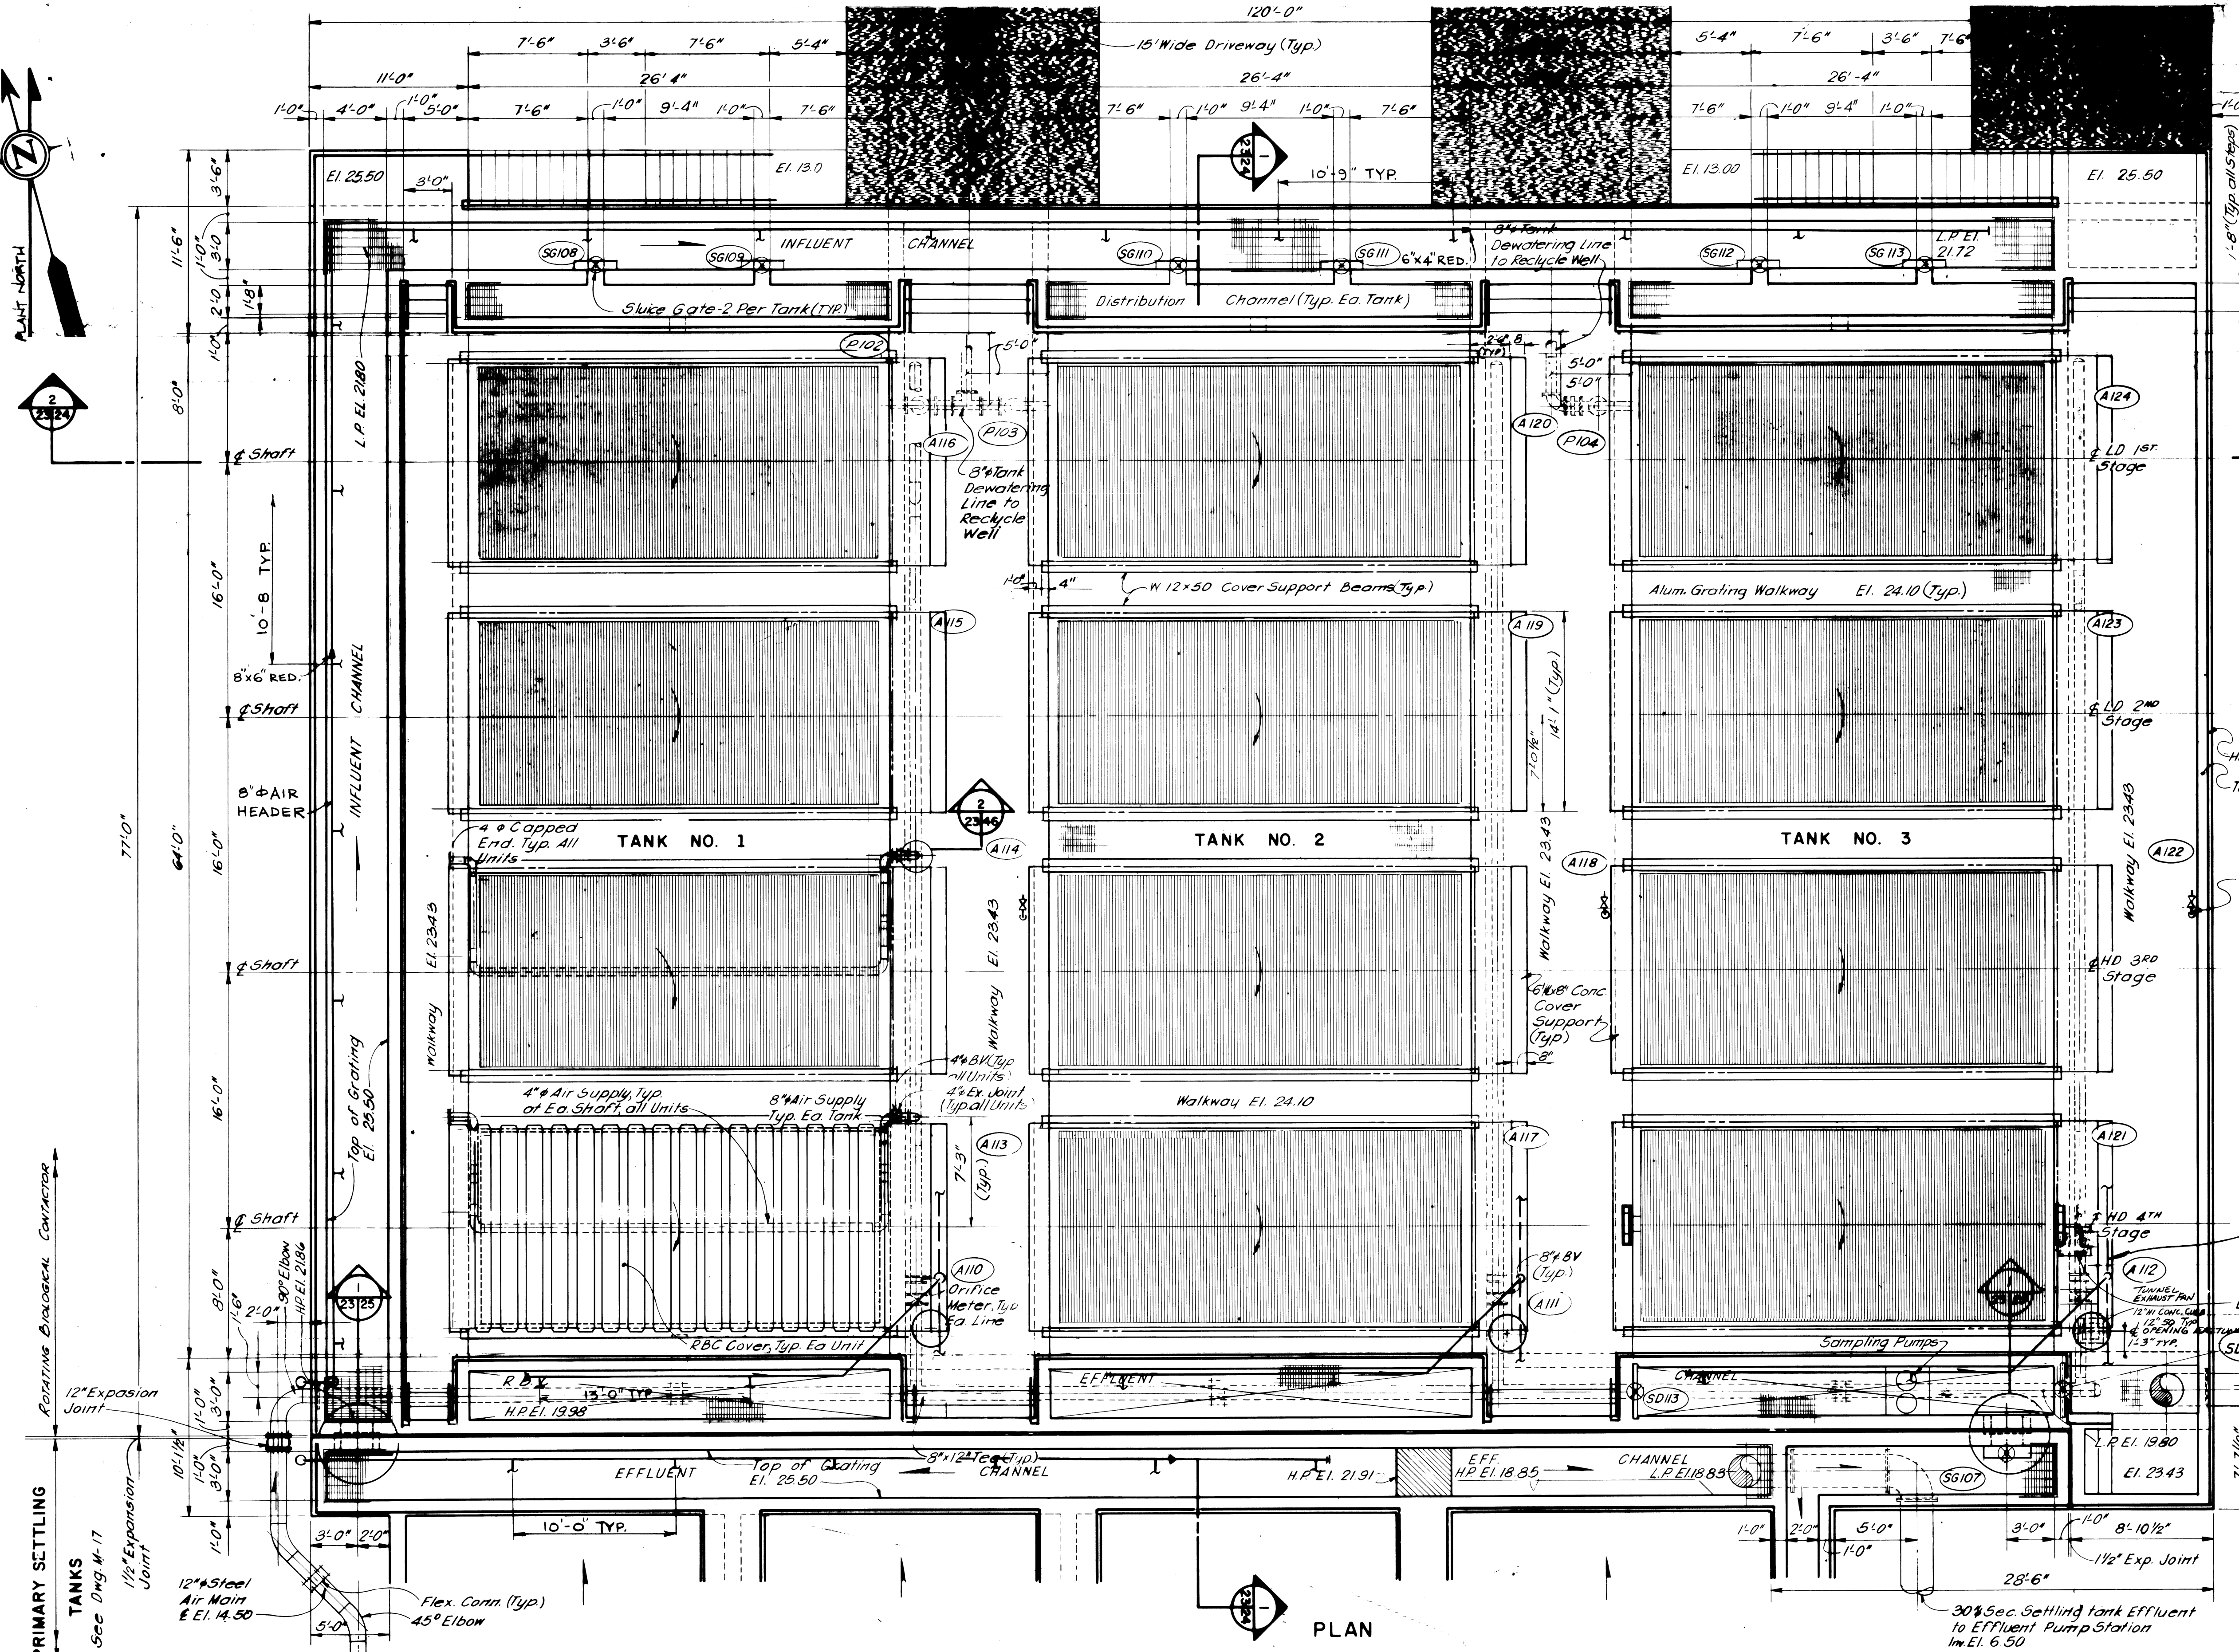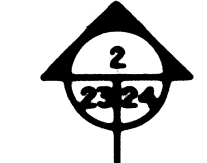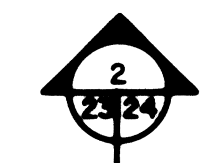

- NOTES
- \* Cut out as required by equipment furnished
  - \*\* Dimension as required by equipment furnished
  - SD Sluice gate
  - SG Sluice gate

- Handrail (Typ)
- Top of Wall El. 25.50
- 1" Hose Bibb Provide Water Service at Each Tunnel (Typ)
- 8" AIR MAIN BELOW TYP.
- Mechanical Drive Unit Typ Each Unit
- 30" Effluent to Distribution Box in El. 6.50

PLAN

MODIFICATIONS AS RECORDED DURING CONSTRUCTION  
**RECORD DRAWING**

**PANDULLO QUIRK ASSOCIATES**  
 Science Engineering Design

DESIGNED EA  
 DRAWN EA  
 CHECKED FS

APPROVALS  
 PROJ. MGR. J.O'B  
 PROJ. ENGR. D.J.E

**FRANCIS PANDULLO**  
 PROFESSIONAL ENGINEER  
 N.J. LIC. NO. 11626 DATE






CAPE MAY COUNTY MUNICIPAL UTILITIES AUTHORITY  
 CAPE MAY COUNTY NEW JERSEY  
 CAPE MAY REGION  
**WASTEWATER TREATMENT FACILITIES**

ROTATING BIOLOGICAL CONTACTORS  
 PLAN

PROJECT NO. 61516  
 SCALE: 3/16" = 1'-0"  
 DWG. M-23 OF 47  
 SHEET 30



REVISIONS				
DATE	BY	CHKD	APP'D	DESCRIPTION
12-30-81	BR	FJB	FS	CHANNEL AIR ADDITIONS

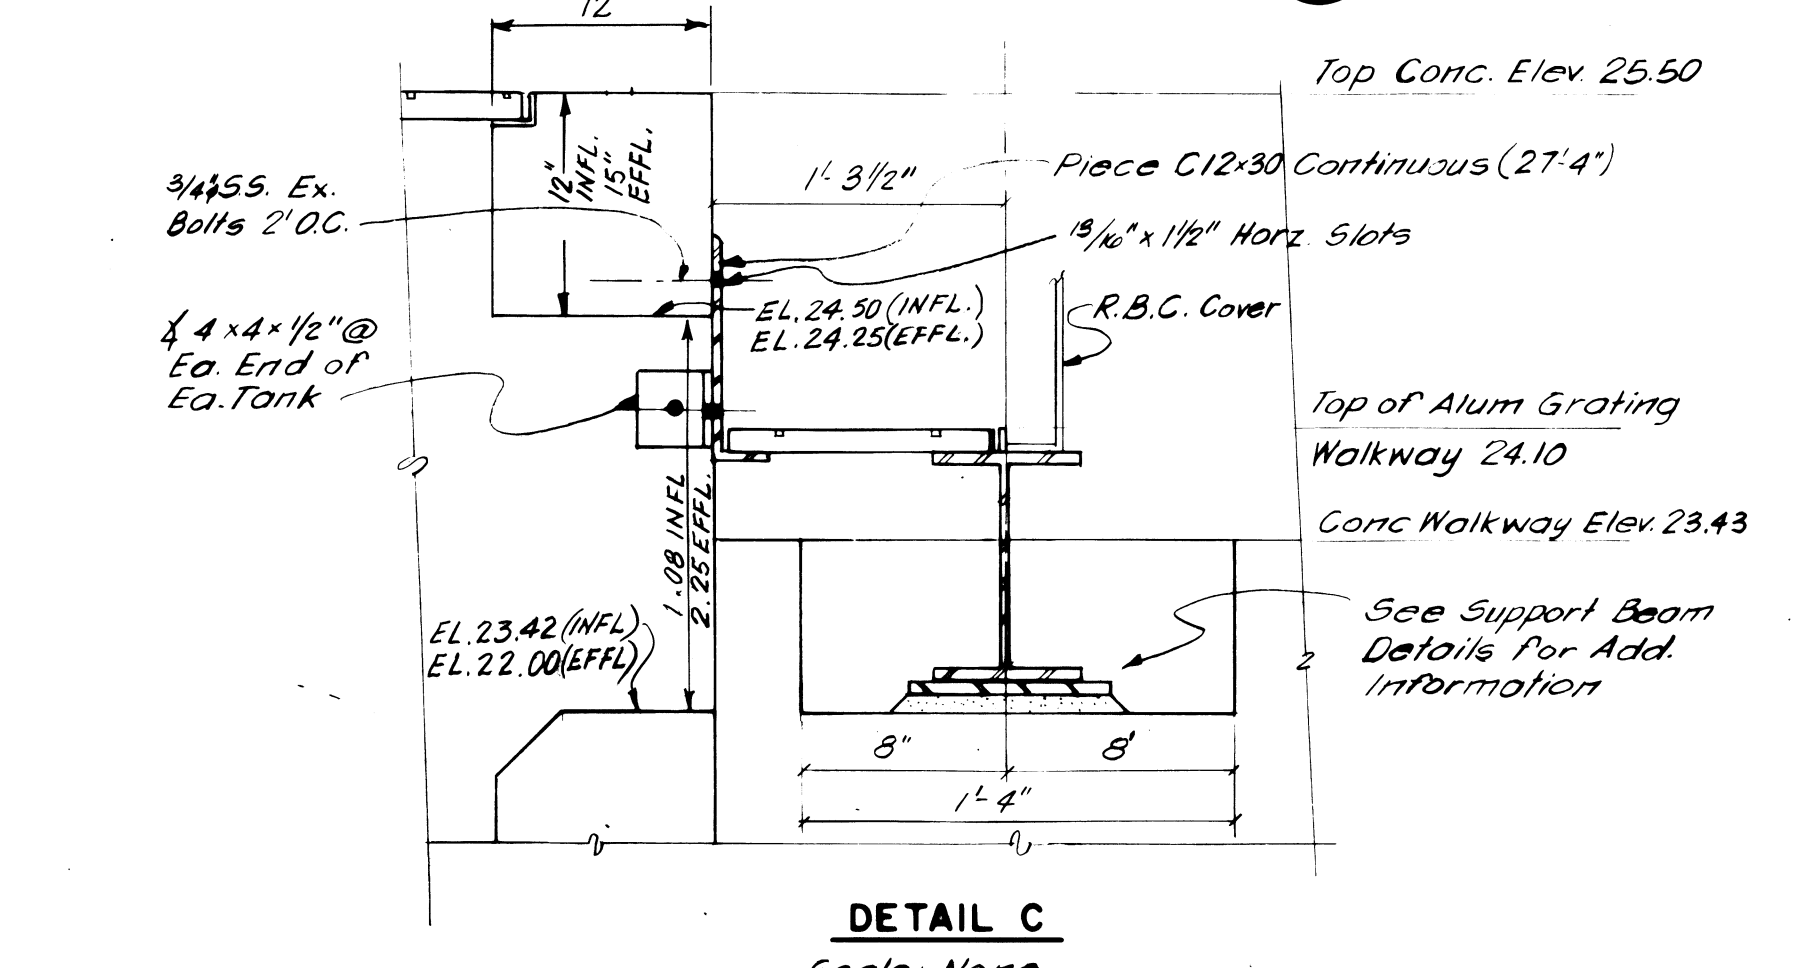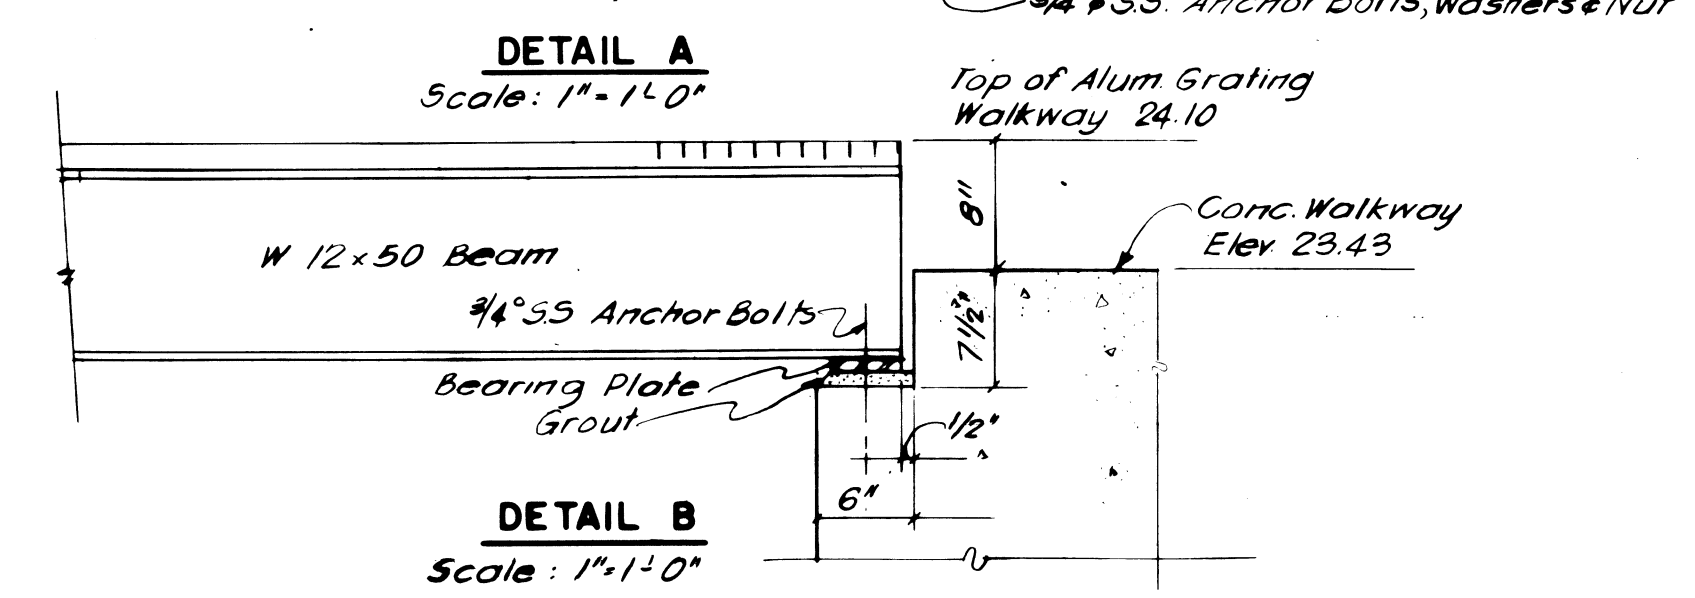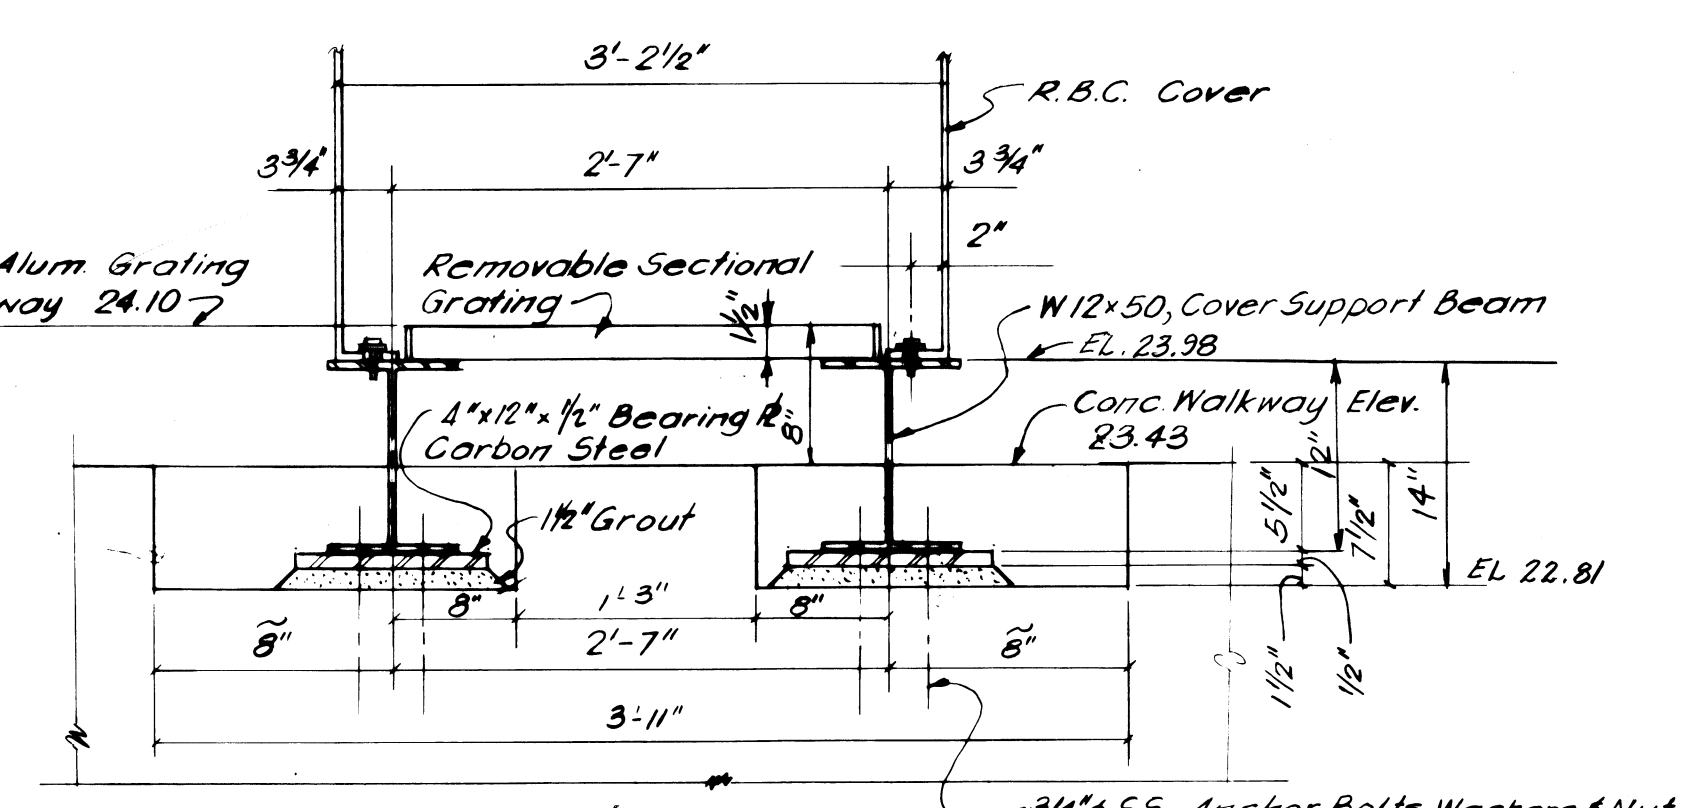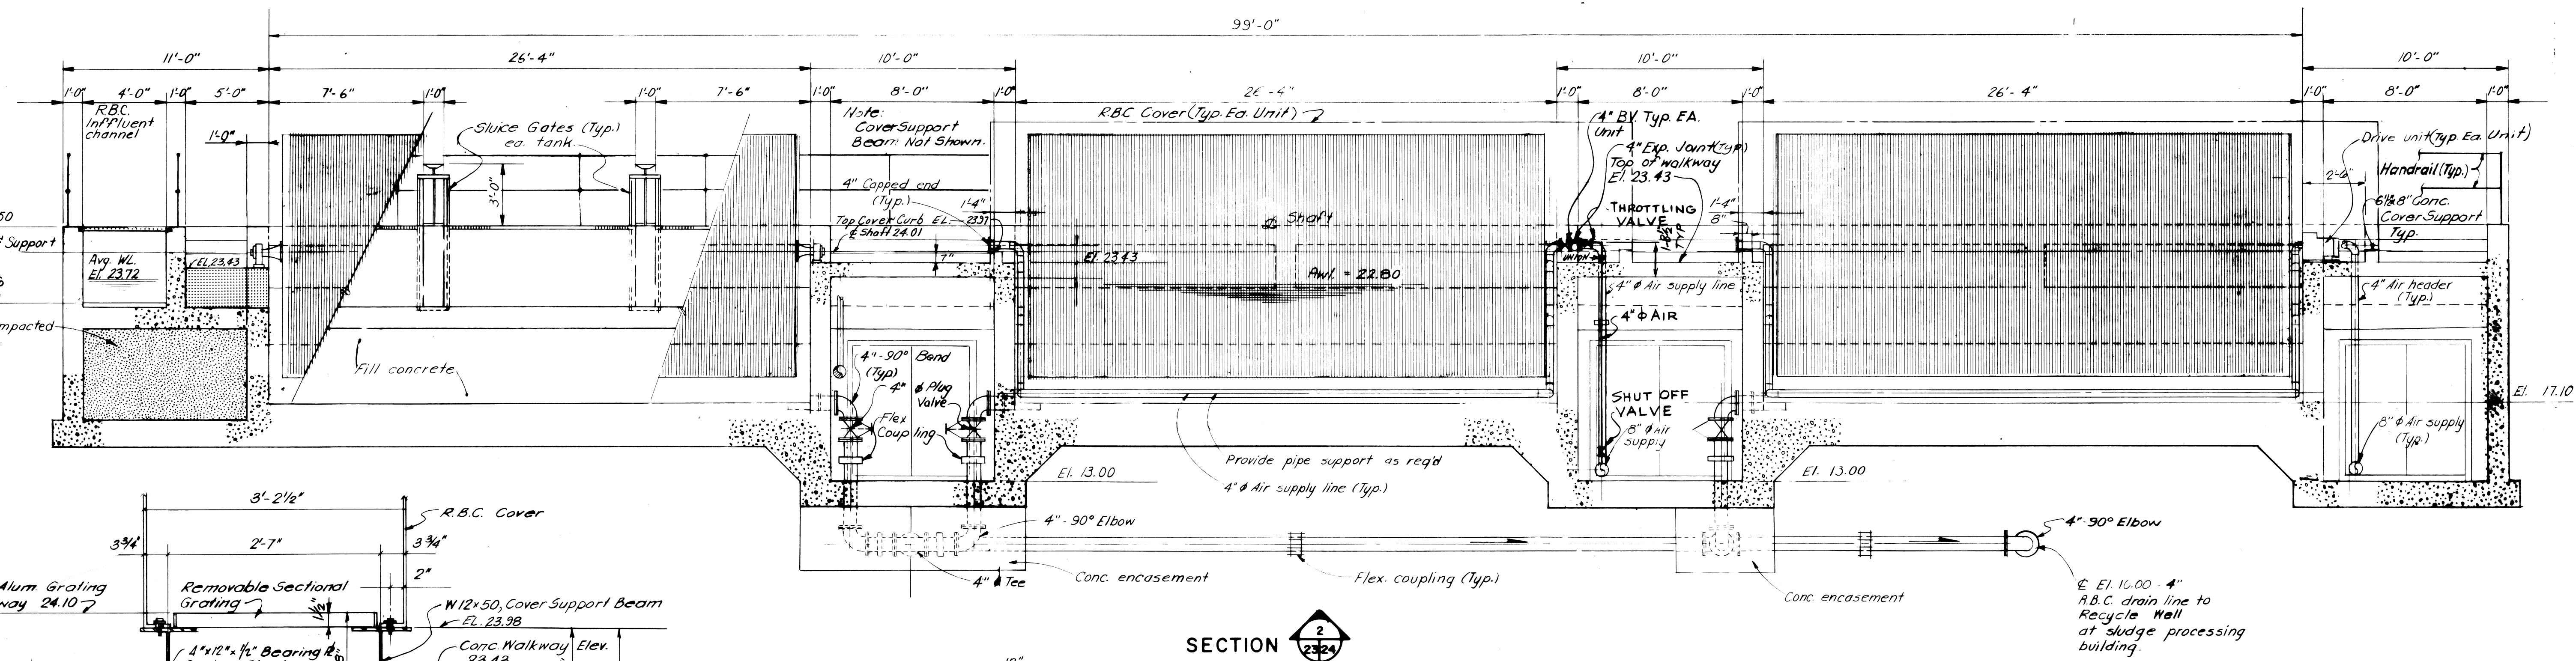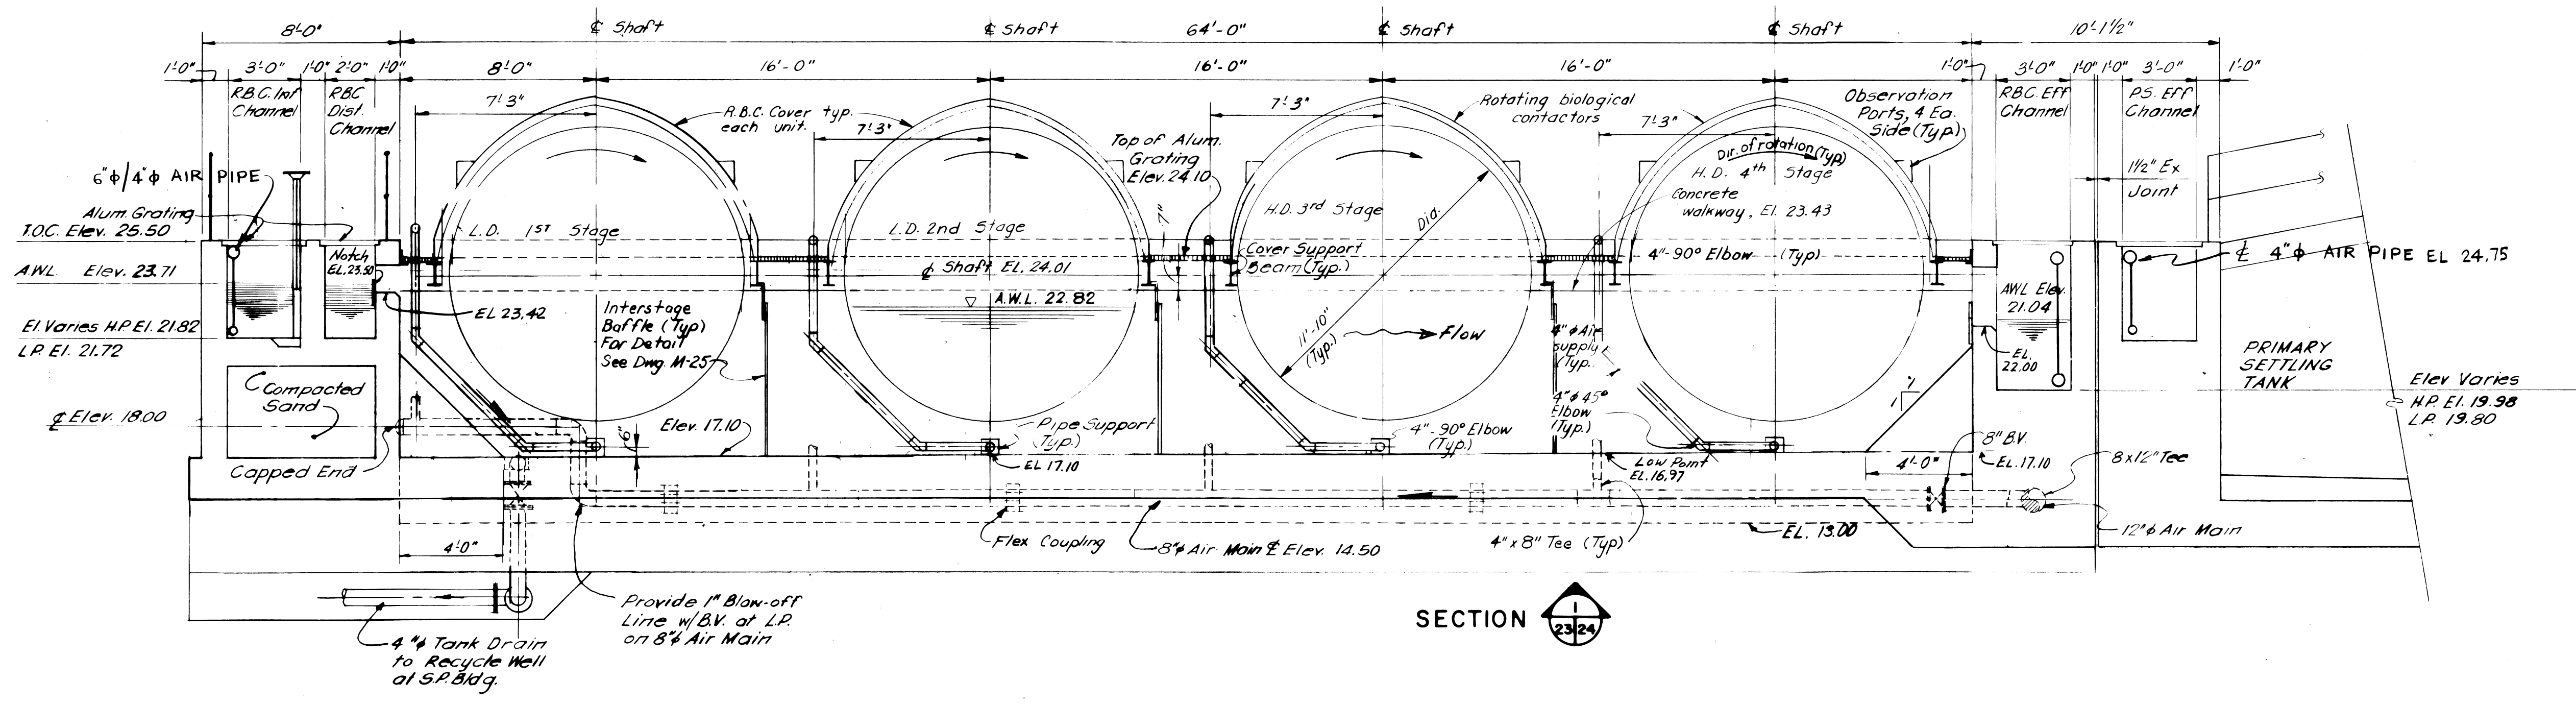

RBC COVER AND GRATING SUPPORT DETAILS

**PANDULLO QUIRK ASSOCIATES**  
 Science Engineering Design

DESIGNED EA  
 DRAWN EA/ML  
 CHECKED FS

APPROVALS  
 PROJ. MGR. JOB  
 PROJ. ENGR. FS  
**Francis Pandullo**  
 PROFESSIONAL ENGINEER  
 N.J. LIC. NO. 11626 DATE: 12-31-81

CAPE MAY COUNTY MUNICIPAL UTILITIES AUTHORITY  
 CAPE MAY COUNTY NEW JERSEY  
 CAPE MAY REGION  
 WASTEWATER TREATMENT FACILITIES

ROTATING BIOLOGICAL CONTACTORS  
 SECTIONS

PROJECT NO. 61516  
 SCALE: 1/4" = 1'-0"  
 DWG. M-24 OF 47  
 SHEET 31

MODIFICATIONS AS RECORDED DURING CONSTRUCTION  
**RECORD DRAWING**